

DEPARTMENT OF INDUSTRY,
LABOR & HUMAN RELATIONS
P.O. BOX 7969
MADISON, WI 53707

**INSPECTION REPORT FOR
ON-SITE SEWAGE SYSTEMS**

SAFETY & BUILDING
DIVISION
OFFICE OF DIVISION CODES & APPLICATION

NW SW 16-29-12 lot 15 Bldg. Pick Nick Point Addn.

CONVENTIONAL ☐ ALTERNATIVE ☐
Holding Tank ☒ In-Ground Pressure ☐ Mound

State Plan I.D. Number:
(if assigned)
S90-40225

NAME OF PERMIT HOLDER:	ADDRESS OF PERMIT HOLDER:	INSPECTION DATE:
Randy Kjos	Route 2, Colfax, WI 54730	July 26, 1990
BENCH MARK (Permanent reference point) DESCRIBE IF DIFFERENT FROM PLAN: E6394 474 D. Buconille		
Screw in northwest corner of house		
Name of Plumber:	County:	Sanitary Permit Number:
Joe Menter	29.216.00707 Dunn	137756

SEPTIC TANK/HOLDING TANK:

MANUFACTURER:	LIQUID CAPACITY:	TANK INLET ELEV.:	TANK OUTLET ELEV.:	WARNING LABEL PROVIDED:	LOCKING COVER PROVIDED:
Midwest Precast	2000	92.28		☒ YES ☐ NO	☒ YES ☐ NO
BEDDING:	VENT DIA.:	VENT MATL.:	HIGH WATER ALARM:	ROAD:	PROPERTY LINE:
☒ YES ☐ NO	4"	C.I.	☒ YES ☐ NO	10' r.o.w.	10'
DOING CHAMBER:		PUMP/SIPHON MANUFACTURER:		LOCKING COVER PROVIDED:	
BEDDING: ☐ YES ☐ NO				☐ YES ☐ NO	
GALLONS PER CYCLE: (DIFFERENCE BETWEEN PUMP ON AND OFF)		PUMP AND CONTROLS OPERATIONAL: ☐ YES ☐ NO		BUILDING: VENT TO FRESH AIR INLET: ☐ YES ☐ NO	

SOIL ABSORPTION SYSTEM:

Check the soil moisture at the depth of plowing or excavation. (If soil can be rolled into a wire, construction shall cease until the soil is dry enough to continue.)	
CONVENTIONAL SYSTEM:	
FORCE MAIN	DIAMETER: MATERIAL AND MARKING:

CONVENTIONAL SYSTEM:

BED/TRENCH DIMENSIONS	WIDTH:	LENGTH:	NO. OF TRENCHES:	DISTR. PIPE SPACING:	COVER MATERIAL:	PIT	INSIDE DIA.:	# PITS:	LIQUID DEPTH:
GRAVEL DEPTH BELOW PIPES:	FILL DEPTH ABOVE COVER:	DISTR. PIPE ELEV. INLET:	DISTR. PIPE ELEV. END:	DISTR. PIPE MATERIAL:	NO. DISTR. PIPES:	NUMBER OF FEET FROM NEAREST	PROPERTY LINE:	WELL:	BUILDING: VENT TO FRESH AIR INLET:

MOUND SYSTEM:

Check the texture of the fill material for mound systems to make certain that it meets the criteria for medium sand.	PROVIDE A DIAGRAM OF SYSTEM ON REVERSE SIDE. SHOW ELEVATIONS MEASURED.
SOIL COVER	TEXTURE: ☐ YES ☐ NO
DEPTH OVER TRENCH/BED CENTER:	DEPTH OVER TRENCH/BED EDGES:
PERMANENT MARKERS:	OBSERVATION WELLS:
SEEDING: ☐ YES ☐ NO	MULCHED: ☐ YES ☐ NO

PRESSURIZED DISTRIBUTION SYSTEM:

BED/TRENCH DIMENSIONS	WIDTH:	LENGTH:	NO. OF TRENCHES:	LATERAL SPACING:	GRAVEL DEPTH BELOW PIPE:	FILL DEPTH ABOVE COVER:
ELEVATION AND DISTRIBUTION INFORMATION	MANIFOLD ELEV.:	PUMP ELEV.:	MANIFOLD DIA.:	DISTR. PIPE ELEV.:	MANIFOLD MATERIAL:	DISTR. PIPE DIA.:
HOLE SIZE:	HOLE SPACING:	DRILLED CORRECTLY:	COVER MATERIAL:	COVER MATERIAL:	COVER MATERIAL:	COVER MATERIAL:

COMMENTS:

PERMANENT MARKERS:	OBSERVATION WELLS:	NUMBER OF FEET FROM NEAREST	PROPERTY WELL:	BUILDING:
☐ YES ☐ NO	☐ YES ☐ NO	☐ YES ☐ NO	☐ YES ☐ NO	☐ YES ☐ NO

Sketch System on
Reverse Side.

Retain in county file for audit.


SIGNATURE:

Michael Helgason

TITLE:

County Auditor

SBD-6710 (R. 06/88)

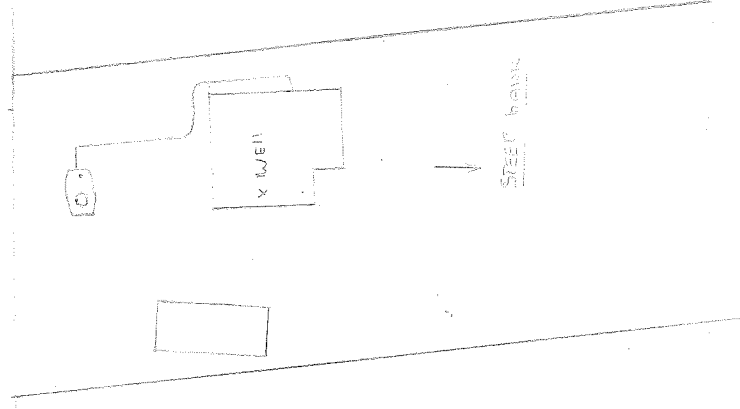

Scale: 1" = 40'

LAKE TAINTER

BM - 100
 INLET = 92.28
~~OUT~~
 COVER = 93.18